



▶ TOUR NOW WITH  Matterport™

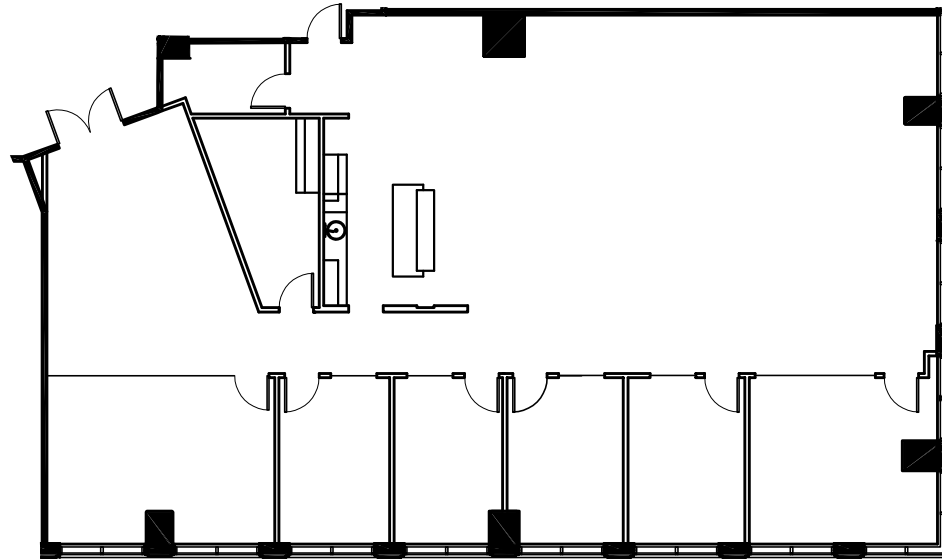

**True North
Not to Scale**

**This Suite has not been verified by NELSON and may not reflect changes made in the field.*

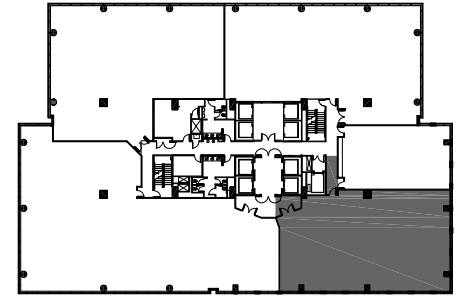

Aileen Almassy 404.925.3321
Andy Sumlin 404.218.1755

NELSON Prominence • Suite 1225 • 4,446 RSF

As-built Diagram